


Land N/F
GMA Properties, LLC
Tax Parcel Id: 145.16-1-2

Land N/F
GMA Properties, LLC
Tax Parcel Id: 145.16-1-4

Niagara Expressway I-190


Military Road (100' Wide)

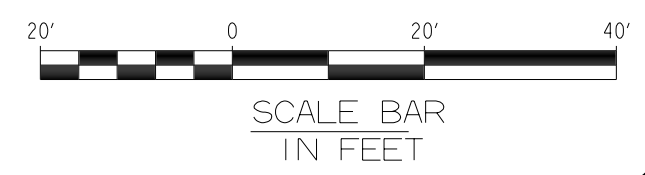

Map
Showing As-Built Survey
of
Property Owned
by
GMA Properties, LLC

Tax ID: 145.16-1-3
Deed Reference: Liber 3421, Page 814

Niagara Boundary
And Mapping Services



2475 MILITARY ROAD
NIAGARA FALLS, NY 14304
(716) 297-9584
FAX: (716) 297-9586
E-MAIL: KLSNBMS@AOL.COM

Serving Western New York
for over 35 years.

UNAUTHORIZED ALTERATION OR ADDITION TO THIS SURVEY MAP IS A VIOLATION OF SECTION 7209, PROVISION 2 OF THE NEW YORK STATE EDUCATION LAW.

THIS SURVEY WAS PREPARED WITHOUT THE BENEFIT OF AN ABSTRACT OF TITLE AND IS SUBJECT TO ANY STATE OF FACTS THAT MAY BE REVEALED BY AN EXAMINATION OF SUCH.

LOT 13 & 14	SECTION 13	TOWNSHIP 13	RANGE 9
Town	Niagara		
COUNTY	Niagara		
STATE	New York		
DATE	December 29, 2011		
SCALE	1" = 20'		
JOB NO.	7619-11		
REVISIONS			

"ONLY COPIES FROM THE ORIGINAL OF THIS SURVEY MARKED WITH AN ORIGINAL OF THE LAND SURVEYOR'S EMBOSSED SEAL SHALL BE CONSIDERED TO BE VALID TRUE COPIES."

THIS SURVEY WAS PREPARED FOR THE PARTIES AND PURPOSE INDICATED HEREON. ANY EXTENSION OF THE USE BEYOND THE PARTIES OR PURPOSE INDICATED IS EXPRESSLY FORBIDDEN WITHOUT WRITTEN RELEASE OR PERMISSION OF THE UNDERSIGNED.

Kenneth L. Slangenhoupt Lic. No. 50349

Map Reference:
Map by James M. McIntyre, P.L.S.
Job No. 29-173 dated August 21, 1996